

### Schenectady County Purchasing Department

620 State St.-2<sup>nd</sup> Floor Schenectady, NY 12305 purchasing@schenectadycountny.gov 518.388.4240

### **ADDENDUM**

\_\_\_\_\_\_

### RFB-2024-52 SCHENECTADY COUNTY JAIL MEDICAL INTERIOR RENOVATIONS C2 DESIGN GROUP

### **ADDENDUM #9**

Issued Date: 1/9/2025

The purpose of this addendum is to provide detailed information to all Bidders. This addendum is hereby included in and made part of the Contract Documents, whether or not attached thereto. Receipt of this Addendum must be acknowledged on the bid form.

CONTENTS/RESPONSE TO QUESTIONS/REFERENCE TO ATTACHMENTS

### General:

- 1. This addendum changes the documents for Bid #RFB-2024-52.
- 2. 01 15 00 Project Master Schedule
  - a. Bid Due/Opening date to Thursday January 16<sup>th</sup>, 2025 @ 2:00 pm.

### **Revised Drawings and Specifications:**


- 1. Delete Drawing G101
  - a. Delete G101 Phasing Plan (See project phasing description below)
- 2. Delete Specification 10 22 10 Wire Mesh Partitions (Addendum #5)
- 3. Drawing D100 Basement Floor Demolition Plan
  - a. Revision #4
- 4. Drawing A900 Schedules
  - a. Revision #4
- 5. Drawing A901 Finish Plan
  - a. Revision #4

### **Project Phasing**

- 1. The project shall be phased in order of work as described below:
  - a. Phase 1a Plumbing contractor (PC) shall install new flush valves in area 701 cells and plumbing chase. General contractor (GC) Modification and new work in Temporary Nursing area.
  - b. Phase 1b (PC) Install new floor drains in area 701 chase and connect piping in basement chase. (GC) to pour new Gypsum Cement based underlayment floor in area 701 chase.
  - c. Phase 2 Once Temporary Nursing area is approved and operational Per County/Jail confirmation, all contracts (GC), (PC), (HVAC) & (EC) to start basement medical area work.

Please acknowledge this addendum on your bid form.

**END OF ADDENDUM #9** 

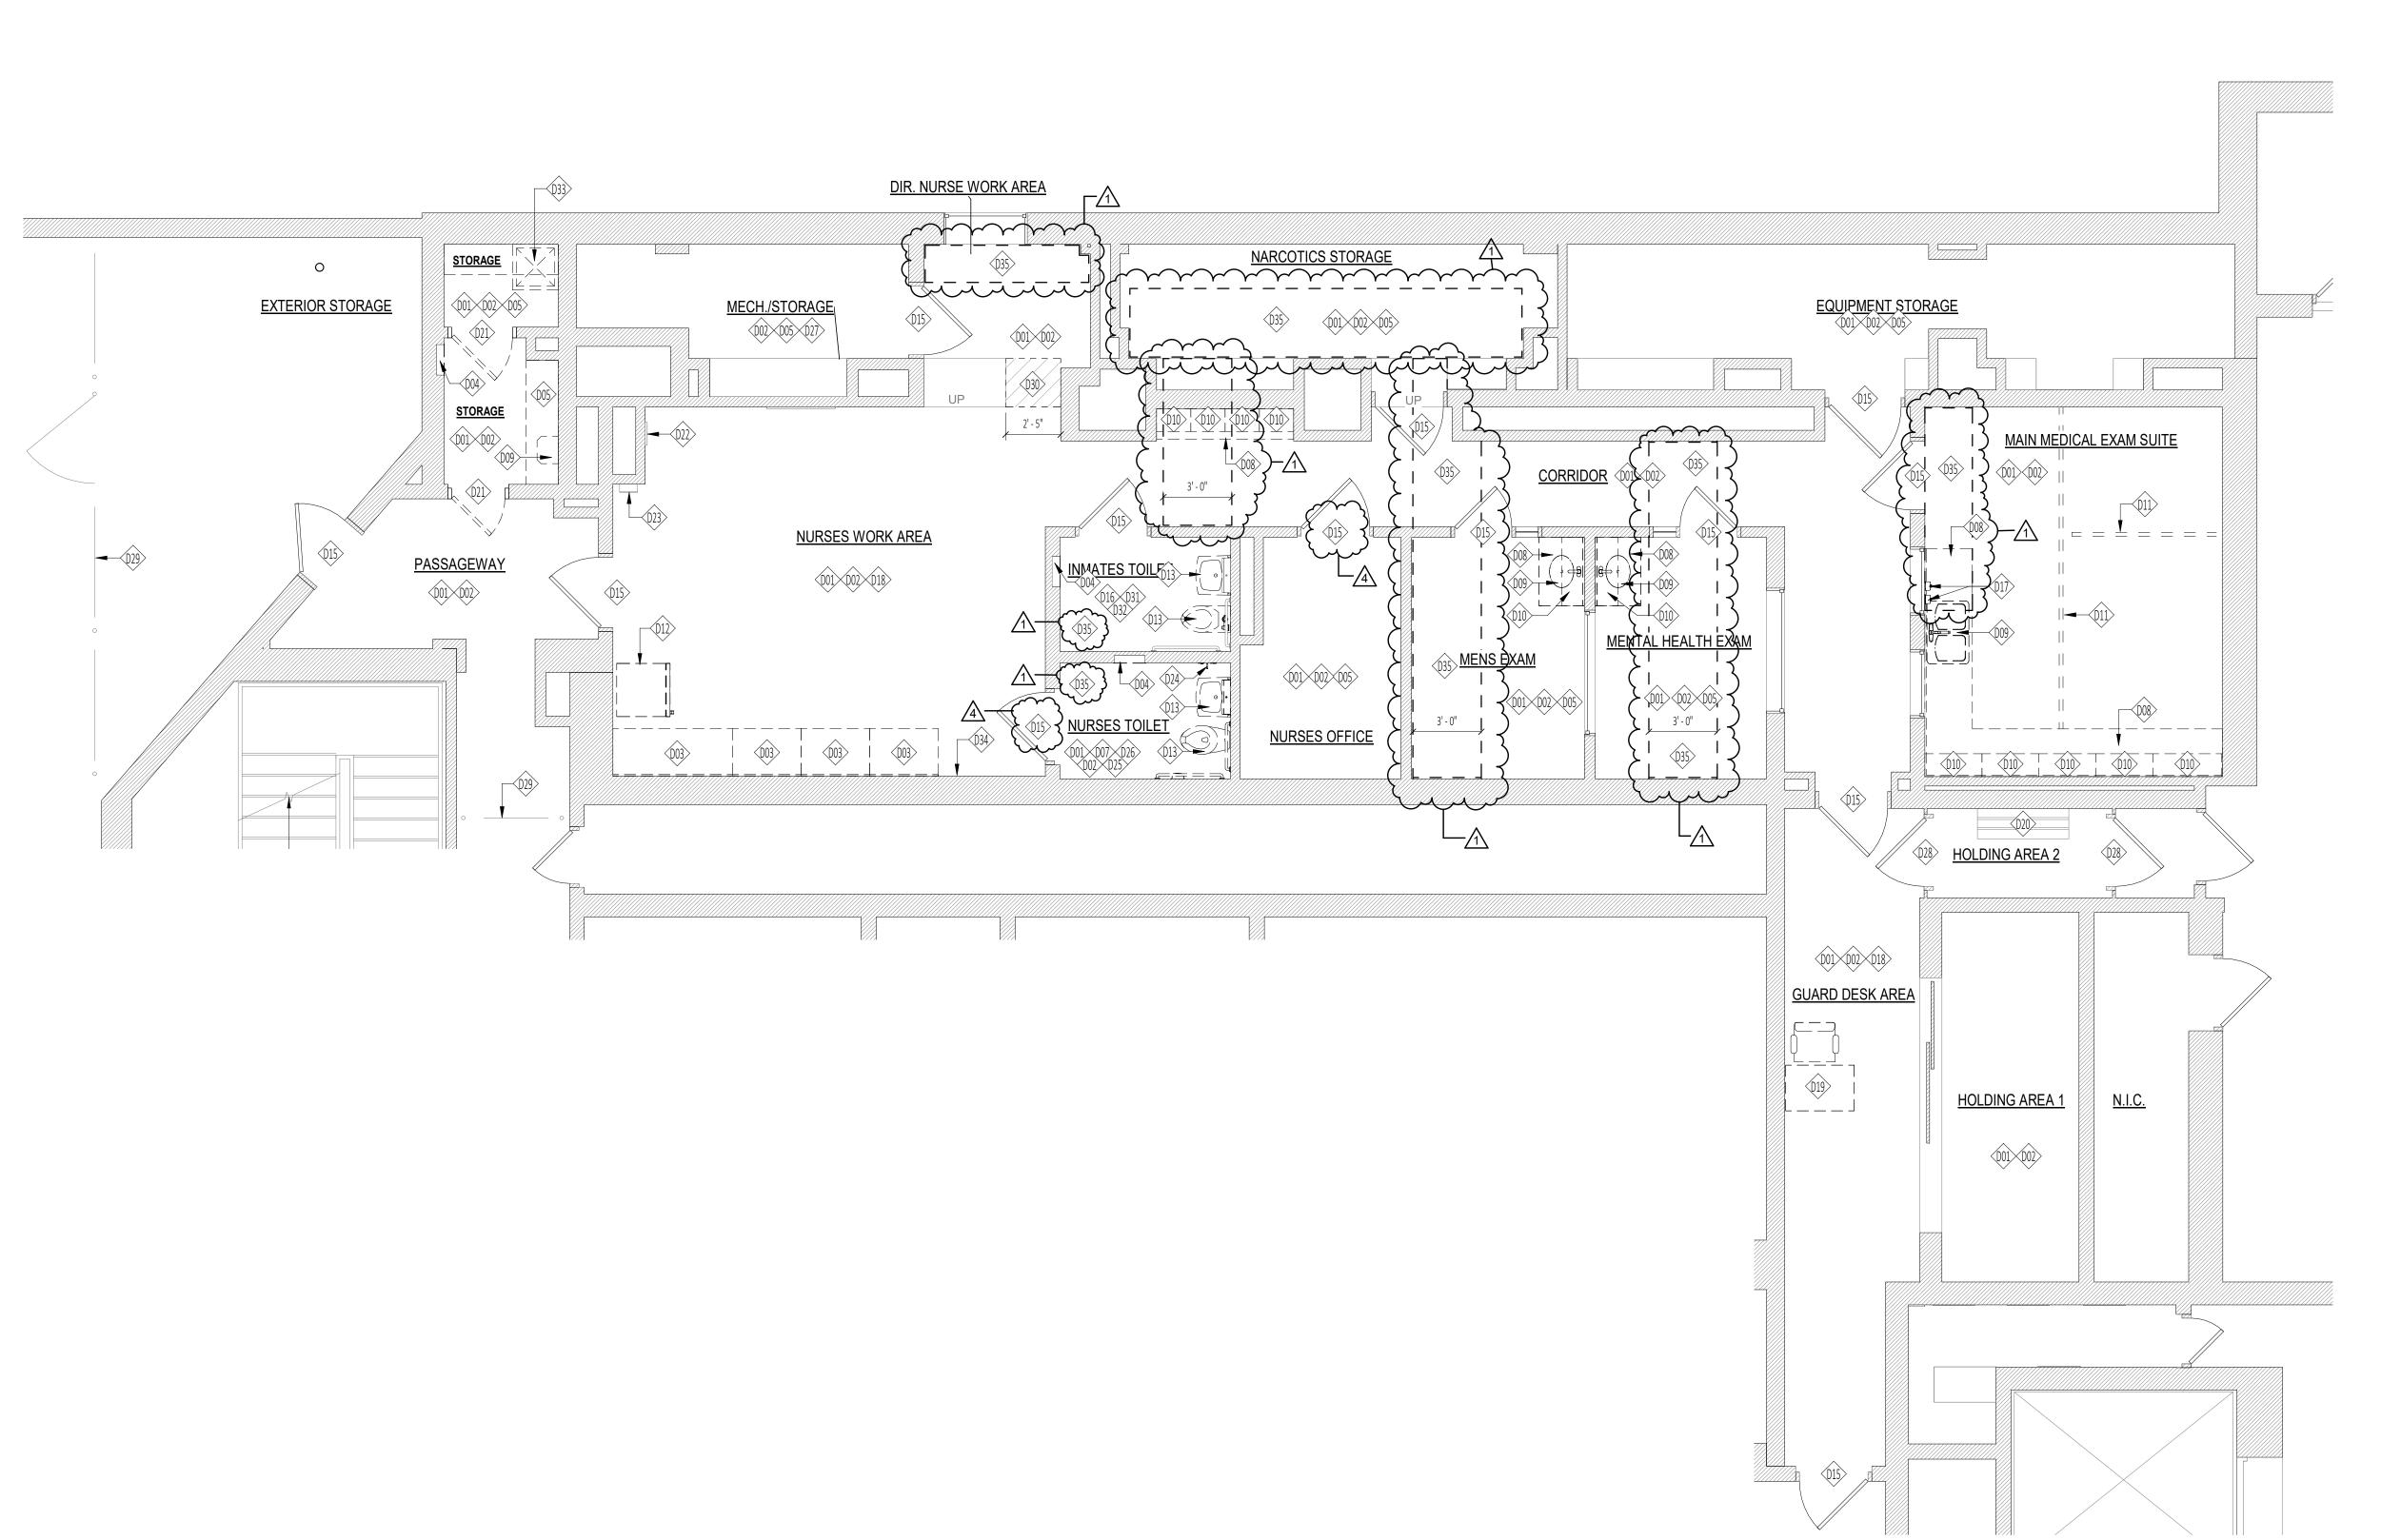

Basement Demolition Plan

D100 | SCALE: 1/4" = 1'-0"

# **General Demolition Notes**

- REFERENCE G102 FOR ADDITIONAL DEMOLITION NOTES. REMOVE ALL EXISTING FLOOR FINISH IN AREA OF WORK AS NOTED BY KEYNOTES. PATCH, REPAIR, AND PREP FLOOR AS REQUIRED FOR NEW WORK. MAINTAIN ALL EXISTING CONTROL JOINTS AND EXPANSION JOINTS.
  - REMOVE ANY AND ALL WALL BASE IN PREPARATION FOR
  - THE WORK REMOVE ALL DAMAGED PLASTER FINISH AT BEAMS,

CEILING , AND WALLS BACK TO STABLE SUBSTRATE

REMOVE EXISTING RECESSED TRASH AND PAPER TOWEL COMBO DISPENSER UNIT

COORDINATE WITH THE WORK

Demolition Floor Plan Legend

FINISH

INFORMATION

REMOVE FLOOR BASE AND FLOOR FINISH DOWN TO

REMOVE EXISTING LIGHT FIXTURES IN THEIR ENTIRETY

MAINTAIN EXISTING WIRING FOR NEW CONNECTION.

REMOVE EXISTING COUNTERTOP AND END PANELS.

DESIGN GROUP

www.C2-DesignGroup.com 24 AIRPORT ROAD

SCHENECTADY, NY 12302

518.320.8250

Owner:

Schenectady County

Schenectady, NY 12305

Schenectady,NY 12302

Schenectady,NY 12305

612 State Street

C2 Architecture

24 Airport Road


M.E. Engineering 433 State Street

Architect:

SEE ELECTRICAL DRAWINGS FOR ADDITIONAL

D01 EXISTING SUBFLOOR, PREP TO RECEIVE SCHEDULED

- REMOVE ALL EXISTING SHELVING UNITS IN THEIR
- **ENTIRETY** REMOVE EXISTING DOOR, FRAME TO REMAIN, ALL
- COMPONENTS AS PART OF THE DOOR SYSTEM SHALL BE REMOVED, UNLESS NOTED OTHERWISE. PREP OPENING FOR NEW REMOVE ALL TOILET ACCESSORIES IN THEIR ENTIRETY
- INCLUDING, BUT NOT LIMITED TO, GRAB BARS, D07 | MIRRORS, PAPER TOWEL DISPENCERS, TOILET PAPER DISPENCERS, SOAP DISPENCERS, AND WASTE RECEPTICALS. COORDINATE WITH THE WORK
- REMOVE EXISTING COUNTERTOP WITH BASE CABINET. COORDINATE WITH THE WORK
- REMOVE EXISTING SINK. MAINTAIN EXISTING PLUMBING LOCATION
- REMOVE EXISTING WALL CABINET. COORDINATE WITH D10 THE WORK
- REMOVE EXISTING CEILING MOUNTED CURTAIN TRACK. COORDINATE WITH THE WORK
- REMOVE EXISTING REFRIGERATOR AND SALVAGE FOR POTENTIAL REUSE
- REMOVE EXISTING PLUMBING FIXTURE IN ITS ENTIRETY AND PREP FOR NEW. COORDINATE WITH THE WORK. REFERENCE PLUMBING DRAWINGS FOR ADDITIONAL INFORMATION
- D15 EXISTING DOOR AND FRAME TO REMAIN
- EXISTING TOILET ACCESSORIES TO REMAIN, INCLUDING BUT NOT LIMITED TO, GRAB BARS, MIRRORS, PAPER TOWEL DISPENCERS, TOILET PAPER DISPENCERS, AND SOAP DISPENCERS
- D17 | remove existing wall mounted soap dispenser
- REMOVE DAMAGED PLASTER FINISH AT BEAMS, CEILING, AND WALLS BACK TO STABLE SUBSTRATE
- D19 REMOVE EXISTING SECURITY DESK AND CHAIR
- TEMPORARY REMOVE AND REPLACE BENCH AND CAGE FOR EPOXY FLOORING
- REMOVE EXISTING DOOR AND FRAME IN ITS ENTIRETY MAINTAIN OPENING FOR NEW PASSAGE OPENING, COORDINATE WITH THE WORK
- D22 EXISTING ACCESS PANEL TO REMAIN
- D23 EXISTING FIRE EXTINGUISHER TO REMAIN
- D24 REMOVE EXISTING RECESSED SOAP DISPENSER
- REMOVE EXISTING WALL TILE. PREP WALL FOR NEW D25
- REMOVE AND REPLACE EXISTING MECHANICAL D26 EXHAUST SYSTEM WITH NEW. SEE MECHANICAL
- DRAWINGS FOR ADDITIONAL INFORMATION EXISTING CONCRETE FLOOR. CLEAN AND PREP FOR
- **NEW FLOOR FINISH** REMOVE AND SALVAGE EXISTING METAL GATE CAGE
- D28 AND DOOR FOR REUSE. PROTECT DURING CONSTRUCTION. COORDINATE WITH THE WORK
- D29 EXISTING FENCE TO REMAIN
- PREP HATCHED AREA OF EXISTING CONCRETE FOR NEW RAMP ADDITION
- REMOVE EXISTING RUBBER BASE AND BOTTOM ROW OF WALL TILE FOR NEW EPOXY BASE. COORDINATE WITH THE WORK
- D32 EXISTING WALL TILE TO REMAIN
- REMOVE AND DISCONNECT EXISTING MOP SINK, CAP BACK TO SOURCE. COORDINATE WITH PLUMBING
- REMOVE LOOSE PLASTER AND CONCRETE AT WATER DAMAGED AREAS (WALLS AND BEAMS) AS REQUIRED.
- REMOVE PORTION OF EXISTING GWB CEILING. COORDINATE WITH MECHANICAL DRAWINGS

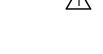





PROJECT NORTH

Sheet Number:

Drawn By:

Job No:

Sheet Title:

PLOT DATE: 1/8/2025 3:43:20 PM

BASEMENT FLOOR

Demolition Plan

RENOVATIONS TO:

SCHENECTADY COUNTY

Jail Medical

320 Veeder Ave Schenectady, NY 12307

BID SET RFB 2024-52

REVISION # DATE:

Addendum #5 11/27/2024

Addendum #9 01/09/2025

C2 Architecture

As Noted

12/10/2024

## Finish Notes

### 1. **GENERAL:**

- a. INTERIOR WALL AND CEILING FINISHES IN EXIT PASSAGEWAYS, CORRIDORS, AND ENCLOSURE FOR EXIT ACCESS STAIRWAYS SHALL BE CLASS B (26-75 FLAME SPREAD INDEX: 0-450 SMOKE-DEVELOPMENT INDEX) OR BETTER, WHEN TESSTED IN ACCORDANCE WITH ASTM E84-2007 OR UL 723-2003
- b. INTERIOR WALL AND CEILING FINISHES IN SPACES OTHER THAN THOSE NOTED ABOVE SHALL BE CLASS C (76-200 FLAME SPREAD INDEX; 0-450 SMOKE DEVELOPMENT INDEX) OR BETTER, WHEN TESTED IN ACCORDANCE WITH ASTM E84-2007 OR UL 723-2003
- c. FLOOR FINISHES SHALL COMPLY WITH THE DOC FF-1 "PILL TEST" CPSC 160CFR PART 1630-2000 d. GC TO PROVIDE TOILET SIGNAGE AS REQUIRED BY THE IBC CHAPTER 11 (AS AMMENDED BY THE STATE BUILDING CODE), TITLE 24 2016 CBC PART 2 VOLUME 1 SECTION 11B (OR AS AMMENDED BY THE STATE ACCESSIBILITY CODE) AND IPC 403.4 (OR AS AMMENDED BY THE STATE PLUMBING CODE).
- REFERENCE ACCESSIBILITY SHEET FOR GENERAL MOUNTING HEIGHTS AND LOCATIONS e. REFERENCE LIFE SAFETY PLAN FOR NOTES RELATED TO COMBUSTIBLE MATERIALS AND PLYWOOD

### SUBSTRATES 2. GENERAL WALL FINISH NOTES:

- a. WHERE EXISTING WALLS ARE TO BE RETAINED AND RE-USED. CONTRACTOR SHALL REPAIR, PATCH AND SAND WALLS AS REQUIRED TO MEET THE OWNERS INTENT AND ACCEPTABLE FOR INSTALLATION OF SPECIFIED FINISHES.
- b. ALL WALLS SHALL BE TAPED AND FINISHED TO A LEVEL 4 STANDARD. IT IS THE RESPONSIBILITY OF THE GC TO INSPECT WALLS AS TAPING AND PATCHING OCCURS TO MEET THE LEVEL 4 STANDARDS AS OUTLINED IN BY THE GWB BOARD MANUFACTURER STANDARDS FOR LEVELS OF DRYWALL, GLASS MAT AND GYPSUM PANEL FINISH. IF THE OWNER FINDS A WALL TO BE UNSATISFACTORY – THE CONTRACTOR SHALL REPAIR THE WALL TO AN ACCEPTABLE LEVEL 4 STANDARD AT THE CONTRACTORS COST
- FINAL APPEARANCE: NO MARKS OR RIDGES. READY FOR PRIMING
- JOINTS AND INTERIOR ANGLES: MINIMUM OF 2 SEPARATE COATS OF COMPOUND ABOVE LEVEL 2 APPLICATION
- ACCESSORIES & FASTENERS: THREE SEPARATE COATS OF COMPOUND
- SURFACE: JOINTS FILLED AND SMOOTHED AGAIN. SHALL BE PRIMED WITH CGC FIRST COAT BEFORE PAINTING OR TEXTURING
- c. PROVIDE CONTROL JOINTS IN WALLS WHICH EXTEND 30' OR GREATED IN LENGTH WITHOUT A JOINT. COORDINATE FINAL LOCATION WITH ARCHITECT.

### 3. **GENERAL PAINTING NOTES:**

- a. PAINTS, COATINGS AND PRIMERS APPLIED TO INTERIOR WALL AND CEILINGS SHALL NOT EXCEED THE VOC CONTENT LIMITS ESTABLISHED IN GREEN SEAL STANDARD GS- 11 PAINTS, FIRST EDITION MAY 20,
- FLATS 50 G/L
- NON-FLATS 150 G/L b. ANTI-CORRISVE AND ANTI-RUST PAINTS APPLIED TO INTERIOR FERROUS METAL SUBSTRATES SHALL NOT EXCEED THE VOC LIMIT OF 250 G/L ESTABLISHED IN THE GREEN SEAL STANDARD GC-02, ANTI-CORROSIVE PAINTS, SECOND EDITION JANUARY 7, 1997
- c. PROVIDE GRAY WALL PRIMER FOR DARK AND HEAVILY SATURATED COLORS
- d. REFERENCE FINISH LEGEND FOR PAINT SELECTION SPECIFICATIONS 4. **GENERAL TILE NOTES:**

- a. REFERENCE FLOOR FINISH LEGEND FOR TILE SELECTION AND TONA STANDARD REFERENCE. b. FLOOR PREPARATION
- PREP FLOOR AS REQUIRED TO MEET THE INSTALLATION METHODS OF TCNA. INTENT IS FOR TILE TO BE INSTALLED OVER CONCRETE SUBSTRATE. IF A CONCRETE SUBSTRATE DOES NOTE EXIST, INFORM THE ARCHITECT
- IF THE SUBSTRATE IS A GYPCRETE FINISH, THE GYPCRETE MUST BE SEALED PRIOR TO ANY TILE INSTALLATION
- FLOOR CRACKS SHALL BE FLASH PATCHED
- c. ALL TILE SHALL BE INSTALLED PER TCNA STANDARDS
- d. PROVIDE EXPANSION JOINTS AND OTHER SEALANT-FILLED JOINTS INCLUDING, CONTRACTOR AND ISOLATION JOINTS PER ALL CURRENT TCNA, EJ171 STANDARDS. FORM JOINTS DURING INSTALLATION OF SETTING MATERIALS, MORTAR BEDS AND TILE. DO NOT SAW-CUT JOINTS AFTER INSTALLING TILES. COORDINATE FINAL LOCATIONS WITH ARCHITECT.
- e. WHERE CONTROL JOINTS OCCUR IN THE SLAB, PROVIDE A 6" WIDE STRIP OF HYDRO-BAN ANTIFRACTURE FABRIC OVER THE JOINT, AND INSTALL IN ACCORDANCE WITH TCNA STANDARDS
- f. ALL OTHER AREAS TO BE TILED:
- PROVIDE LIQUID APPLIED CRACK ISOLATION MEMBRANE IN ACCORDANCE WITH TCNA STANDARDS, AT ALL AREAS TO BE TILED
- PROVIDE CEMENTICIOUS GROUT AT ALL AREAS TO BE TILED UNLESS NOTED OTHERWISE BELOW
- PROVIDE UNSANDED GROUT AT AREAS WHICH CONTAIN GLASS TILES

## 5. WALLCOVERING NOTES:

- a. ALL WALLS TO RECEIVE A WALL COVERING FINISH SHALL BE FINISHED TO A LEVEL 4 MINIMUM
- b. WALL COVERING SHALL BE INSTALLED PER MANUFACTURER SPECIFICATIONS c. CERTAIN COVERINGS CONTAIN AN 'A AND B' PATTERN INSTALLATION. PROVIDE MOCK UP

## 6. **FLOORING NOTES:**

a. CONCRETE FLOORS SHALL BE PREPPED PER RESILIENT FLOORING MANUFACTURER STANDARDS. b. FLOORS SHALL BE FLASH PATCHED TO ALLOW FOR FLUSH TRANSITIONS BETWEEN DISSIMILAR


# Door Schedule

Door No.	Location		DOOR							FRAME						Hardwara	Rating	Comments	Door No.	
DOOLING.	Location		Width	Height	Thk.	Material	Finish	Type	Glazing	Material	Finish	Туре	Head	Jamb	Sill	⊣ Hardware	INalling	Comments	DOOL NO.	-
001	NURSES OFFICE 017 / CORRIDOR 005		3' - 0"	7' - 0"	0' - 1 3/4"	ETR	PT-3	ETR	ETR	ETR	ETR	ETR	ETR	ETR	-	ETR	-	EXISTING DOOR AND FRAME TO REMAIN,ADD FROSTED FILM ON GLASS	001	
001-A	METAL OFFICE 001-C / OPEN AREA 001-1		3' - 0"	6' - 8"	0' - 1 3/4"	WD	PT-3	F	-	НМ	PT-3	1	H1	J1	-	PRIVACY	-	FLUSH PANEL WOOD SOLID CORE DOOR	001-A	_] ^
001-B	STORAGE 001-B / EXISTING STORAGE SPACE		3' - 0"	6' - 8"	0' - 1 3/4"	WD	PT-3	F	-	НМ	PT-3	1	H1	J1	-	PRIVACY	-	FLUSH PANEL WOOD SOLID CORE DOOR	001-B	┛╸
002	NURSES TOILET 016 / NURSES WORK AREA 011		3' - 0"	7' - 0"	0' - 1 3/4"	ETR	PT-3	ETR	-	ETR	ETR	ETR	ETR	ETR	-	ETR	-	EXISTING DOOR AND FRAME TO REMAIN	002	

### Finish Schedule

Room	Room Name	Floo	or		North Wall			East Wall	South Wall			West Wall			Ceiling		Comments	
Number	Room Name	Material	Finish	Material	Finish	Base	Material	Finish	Base	Material	Finish	Base	Material	Finish	Base	Material	Finish	Comments
001	ENTRANCE CORRIDOR	CONC	EP-1	ETR	PT-1	EP-1	ETR	PT-1	EP-1	ETR	PT-1	EP-1	ETR	PT-1	EP-1	ETR	PT-2	
001-A	OPEN AREA STORAGE	CONC	ETR	ETR	ETR	ETR	ETR	ETR / PT-1	ETR/RB-1	ETR	ETR	ETR	ETR	ETR	ETR	ETR	<u>.</u>	
001-B	STORAGE Y Y Y Y Y Y	CONC	Y EYR	Y GWB Y	PT-1 Y	RB-1	GWB	PT-1	RB-1	Y 'ETRY'	r PT-1	r RB-Y	Y GWB	Y PT-Y	RB <sup>1</sup> 1	ETR		,
001-B	NURSES AREA	CONC	ETR	-	-	-	-	-	-	ETR	ETR	ETR	-	-	-	ETR	-	
001-C	MENTAL OFFICE	CONC	ETR	GWB	PT-1	RB-1	GWB	PT-1	RB-1	GWB	PT-1	RB-1	GWB	PT-1	RB-1	ETR	-	
001-D	HOLDING 1	CONC	ETR	-	-	-	-	-	-	ETR	ETR	ETR	ETR	ETR	ETR	ETR	-	
001-E	HOLDING 2	CONC	ETR	ستبا	المر تمر	لىر -لىر	س- سـ	س- سر	ب ت	ETR	ETR	L ETB	L ETR	L ETR	L ETR _	ETR	لىر تىر	m m m m m m m m m
002	GUARD DESK AREA	CONC	EP-1	ETR	PT-1	EP-1	ETR	PT-1	EP-1	ETR	PT-1	EP-1	ETR	PT-1	EP-1	ETR	PT-2	
003	HOLDING AREA 1	CONC	EP-1	ETR	PT-1	FP-1	ETR	PT-1	EP-1	ETR	PT-1	EP-1	ETR	PT-1	EP-1	ETR	PT-2	
004	HOLDING AREA 2	CONC	EP-1	ETR	PT-1 <b>{</b>	EP-1	}-/4\-	-	-	ETR	PT-1	EP-1	<del>}</del> _/4\-	-	-	ETR	PT-2	
005	CORRIDOR	CONC	EP-1	ETR	PT-1	EP-1	ETR	PT-1	EP-1	ETR	PT-1	EP-1	ETR	PT-1	EP-1	ETR	PT-2	
006	MAIN MEDICAL EXAM SUITE	CONC	EP-1	ETR	PT-5	EP-1	ETR	WC-1	EP-1	ETR	PT-5	EP-1	ETR	PT-5	EP-1	ETR	PT-2	
007	EQUIPMENT STORAGE	CONC /4	EP-1	ETR	PT-1	EP-1	ETR	PT-1	EP-1	ETR	PT-1	EP-1	ETR	ETR	EP-1	▲ ETR	PT-2	
800	NARCOTICS STORAGE	CONC	EP-1	ETR	PT-1	EP-1	ETR	PT-1	EP-1	ETR	PT-1	EP-1	ETR	PT-1	EP-1	ETR	PT-2	
009	DIR. NURSE WORK AREA	CONC	EP-1	ETR	PT-1	EP-1	<b>}</b> ETR	PT-1	EP-1	4-	-	- [4	ETR	PT-1	EP-1	} ETR	PT-2	
010	MECH./STORAGE	CONC	EP-1	ETR	PT-1	EP-1	ETR	PT-1	EP-1	ETR	PT-1	EP-1	ETR	PT-1	EP-1	ETR	PT-2	
011	NURSES WORK AREA	CONC	EP-1	ETR	PT-1-4	EP-1	ETR	PT-1	EP-1	ETR	PT-1	EP-1	ETR	PT-1	EP-1	ETR	PT-2	
012	KITCHENETTE	CONC	EP-1	ETR	PT-1	EP-1	<b>§</b> ETR	PT-1	EP-1	ETR	PT-1	EP-1	ETR	PT-1	EP-1	ETR	PT-2	
013	EXTERIOR STORAGE	=		_	-	<del>~~~~~~</del>	-	-		4 -	-		4 -	-	<u>.</u>	-	-	
014	PASSAGEWAY	CONC 4	EP-1	ETR	PT-1/4\{	EP-1	ETR	PT-1	EP-1	<b>B</b> ETR	PT-1	EP-1	ETR	PT-1	EP-1	} ETR	PT-2	
015	INMATES TOILET	CONC	EP-1	ETR	ETR	EP-1	ETR	ETR	EP-1	ETR	ETR	EP-1	∧ ETR	ETR	EP-1	T ETR	PT-2	
016	NURSES TOILET	CONC A	EP-1	ETR	WT-1	WT-1	ETR	WT-1	WT-1	ETR	WT-1	WT-1	74\ <sub>ETR</sub>	WT-1	WT-1	74\ <sub>ETR</sub>	PT-2	
017	NURSES OFFICE	CONC 4	EP-1	ETR	PT-1/4	EP-1	ETR	PT-1	EP-1	ETR	PT-1	EP-1	<b>}</b> ETR	PT-1	EP-1	<b>}</b> ETR	PT-2	
018	MENS EXAM	CONC	EP-1	ETR	PT-1	EP-1	ETR	PT-1	EP-1	4 ETR	PT-1	EP-1	ETR	PT-1	EP-1	ETR	PT-2	
019	MENTAL HEALTH EXAM	CONC	EP-1	ETR	PT-1	EP-1	ETR	PT-1	EP-1	ETR	PT-1	EP-1	ETR	PT-1	EP-1	ETR	PT-2	

# 

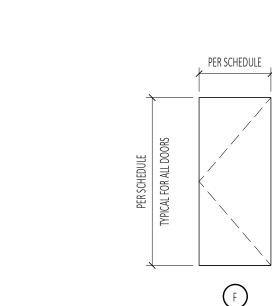

Door Types

- MANUFACTURER: JELD-WEN TYPE: FLUSH PANEL WOOD SOLID CORE DOOR
- DOOR FINISH: PAINTED (PT-3)

## Hardware Schedule

- HARDWARE SETS LISTED ARE TO BE USED AS A BASIS OF DESIGN AND ARE NOT ALL INCLUSIVE OF COMPONENTS NEEDED FOR A FULLY FUNCTIONAL HARDWARE SET. GC SHALL PROVIDE SUBMITTAL FOR OWNER APPROVAL, FOR FULLY FUNCTIONAL SET. FINAL SELECTIONS SHALL BE APPROVED BY
- THE TENANT. COORDINATE KEYING WITH OWNER PRIOR TO ORDERING
- INTERIOR HARDWARE SHALL BE GRADE 2.
- DOOR LEVERS SHALL BE LEVER STYLE, SIMLAR TO SCHLAGE JUPITER 626 (US26D)

## PASSAGE (F75):


- (3) EA STANDARD HINGES (1) EA LEVER SET
- (1) EA WALL STOP (3) EA SILENCERS, COLOR TO MATCH FRAME

# PRIVACY (F76):

- (3) EA STANDARD HINGES
- (1) EA LEVER SET (1) EA WALL STOP
- (3) EA SILENCERS, COLOR TO MATCH FRAME

# Jamb Details

Frame Types

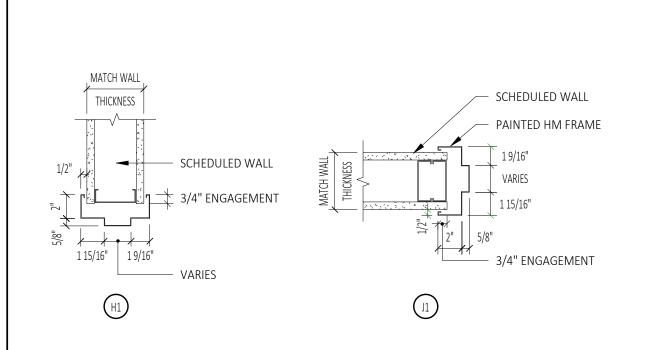

# Resinous Flooring Notes


## NEW WORK SURFACE PREPARATION (ALL RESINOUS FLOORING)

- a. REMOVE, REPAIR, AND PATCH ALL AREAS OF DAMAGED OR NON DURABLE CONCRETE IN SCOPE OF WORK FOR ALL PHASES
- b. REPAIR AND PATCH ALL AREAS OF SURFACE IRREGULARITIES SUCH AS, BUT NOT LIMITED TO:

muniment in the second second

- CRACKS, HOLES, AND JOINTS DAMAGE PRIOR TO PREPPING SURFACE FOR NEW FINISH REMOVE ALL CONTAMINANTS ON ALL CONCRETE SURFACES WITHIN SCOPE OF WORK AREAS,
- INCLUDING BUT NOT LIMITED TO: PAINT, OIL, WAX, DEBRIS, ETC. PRIOPR TO PREPPING THE SURFACE FOR NEW FINISH d. PROVIDE REQUIRED SURFACE PROFILE AS RECOMMENDED BY NEW FLOORING MANUFACTURER
- WORK NOT LIMITED TO: GRINDING, BLAST CLEANING, AND SCARIFYING, ETC. GRIND ALL EXISTING TERRAZZO SURFACES AND PREP FOR NEW WORK CONTRACTOR SHALL BE RESPONSIBLE TO LOCATE AND IDENTIFY ALL CONSTRUCTION JOINTS
- AND CRACK ISOLATION JOINTS. ALL CONTROL JOINTS AND EXPANSION JOINTS ARE TO BE HONORED AND MAINTAINED.
- PREPARE ALL EXISTING FLOOR TYPES FLUSH WITH OTHER ADJACENT FLOORS IN SCOPE AREA
- AND/OR ROOM. PREP AS REQUIRED FOR NEW FLOOR FINISH.
- RESINOUS FLOORING FINISH SHALL BE INSTALLED PER SPECIFICATIONS AND APPROVED MANUFACTURER'S RECOMMENDATIONS

# Interior Glass Wall Types

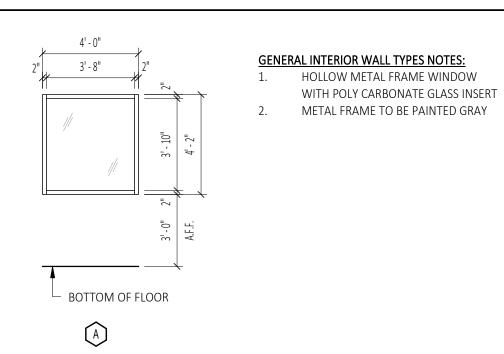


an and the commentation of the comments of the

1. FRAMES TO BE KNOCKED-DOWN FRAMED TO BE PAINTED (PT-3)

2"... SCHEDULED

DOOR WIDTH

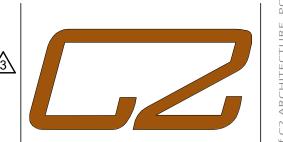


DESIGN GROUP www.C2-DesignGroup.com 24 AIRPORT ROAD SCHENECTADY, NY 12302 518.320.8250

Schenectady County 612 State Street Schenectady, NY 12305

> Architect: C2 Architecture 24 Airport Road Schenectady, NY 12302

> M.E. Engineering 433 State Street Schenectady, NY 12305

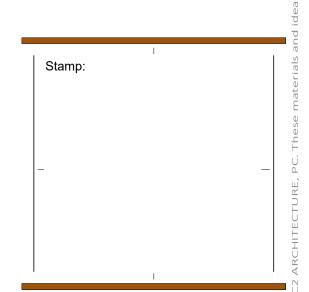

RENOVATIONS TO:

SCHENECTADY COUNTY Jail Medical

320 Veeder Ave Schenectady, NY 12307

## BID SET RFB 2024-52


No.	REVISION#	DATE:
3	Addendum #6	12/12/2024
4	Addendum #9	01/09/2025

Drawn By:	C2 Architecture
Scale:	As Noted
Date:	12/10/2024
Job No:	2412
Sheet Title:	

SCHEDULES

Sheet Number:

PLOT DATE: 1/8/2025 3:43:21 PM

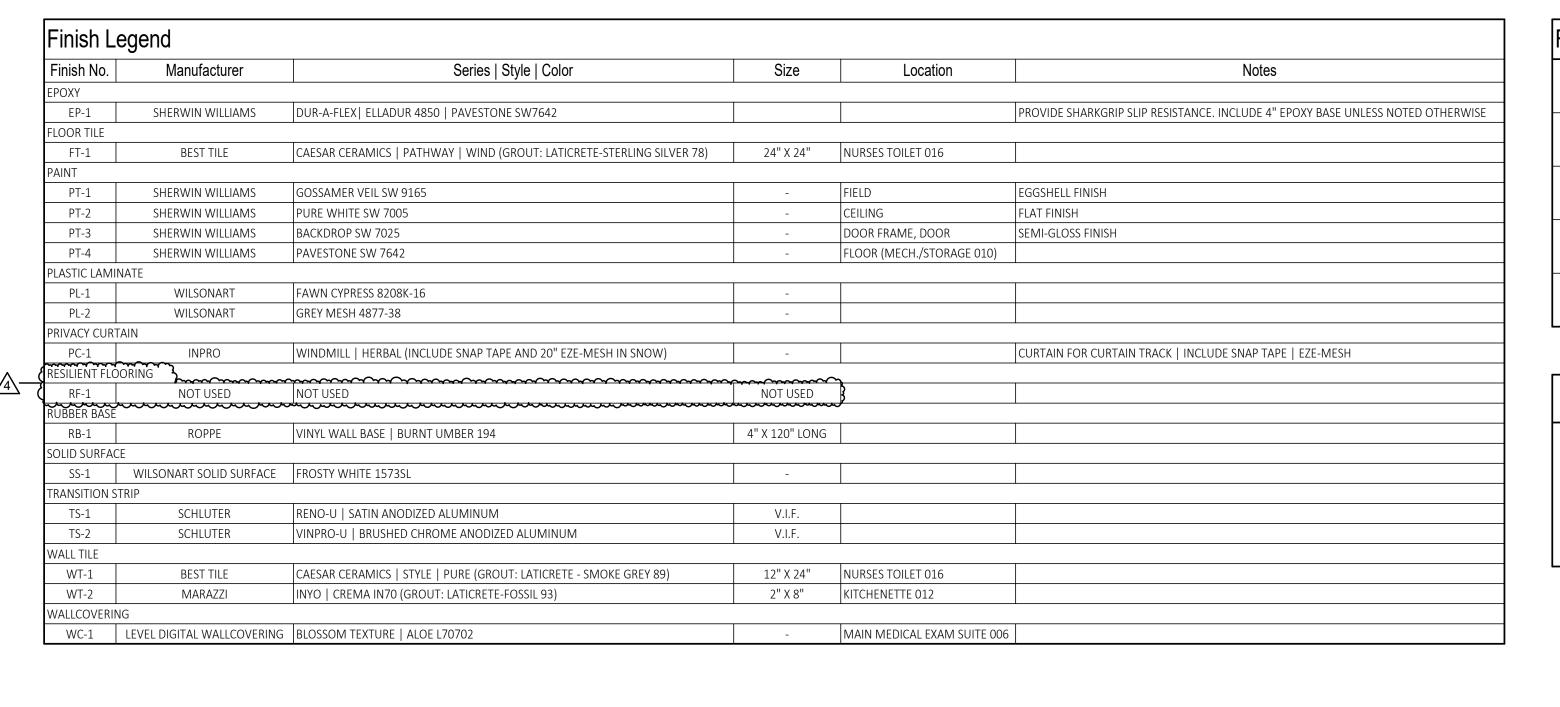

\_\_\_ EP-1

NURSES OFFICE 017

NURSES TOILET

MENS EXAM

EP-1

MENTAL HEALTH EXAM 019

— EP-1

ENTRANCE CORRIDOR

DIR. NURSE WORK AREA

MECH./STORAGE

NURSES WORK AREA 011

\_\_\_\_ EP-1

**EQUIPMENT STORAGE** 

GUARD DESK AREA

∠ EP-1
—

MAIN MEDICAL EXAM SUITE


HOLDING AREA 2

HOLDING AREA 1



# **General Finish Notes**

ALL EXISTING METAL DOOR FRAMES TO BE PAINTED (PT-3) ALL EXISTING METAL DOORS TO BE PAINTED (PT-3)

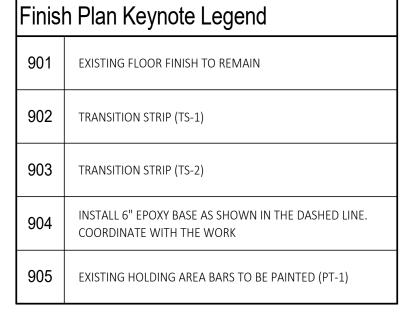

DESIGN GROUP

www.C2-DesignGroup.com

24 AIRPORT ROAD

SCHENECTADY, NY 12302

518.320.8250

Owner:

Architect:

C2 Architecture

24 Airport Road

M.E. Engineering 433 State Street

Schenectady County 612 State Street

Schenectady, NY 12305

Schenectady,NY 12302

Schenectady,NY 12305

RENOVATIONS TO: SCHENECTADY COUNTY

320 Veeder Ave Schenectady, NY 12307


JAIL MEDICAL

No.	REVISION #	DATE:
ino.		
4	Addendum #9	01/09/2025

Drawn By:	C2 Architecture						
Scale:	As Noted						
Date:	12/10/2024						
Job No:	2412						
Sheet Title:							
FINISH PLAN							
1							

Sheet Number:



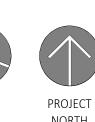



EXTERIOR STORAGE

<u>KITCHENETTE</u>

**PASSAGEWAY** 

901>

PLOT DATE: 1/8/2025 3:43:21 PM

A901